

STATE ENGINEER
Salem, Oregon

Well Record

STATE WELL NO. 17/4W-1N
COUNTY Lane
APPLICATION NO. GR-3705


11624

OWNER: Noah E. Glass MAILING ADDRESS: 601 Wilkes Drive

LOCATION OF WELL: Owner's No. # 1 CITY AND STATE: Eugene, Oregon

SW 1/4 SW 1/4 Sec. 1 T. 17 N. S. R. 4 E. W., W.M.

Bearing and distance from section or subdivision corner 133.96 feet North and 1889.13 feet East of the NW Corner, Lawrence Poindexter DIC 52

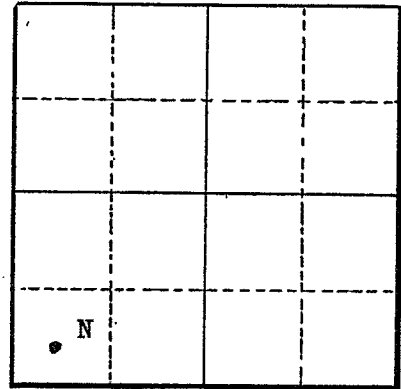

Altitude at well 360 feet

TYPE OF WELL: Driven Date Constructed 1951

Depth drilled 22 feet Depth cased 22 feet

Section 1

CASING RECORD:

3-inch casing (2 in to 1 1/2) set from 19 to 22 feet

FINISH:

slotted 19 to 22

AQUIFERS:

WATER LEVEL:

not tested

PUMPING EQUIPMENT: Type Fairbanks Morse H.P.
Capacity 200 G.P.M.

WELL TESTS:

Drawdown ft. after hours G.P.M.
Drawdown ft. after hours G.P.M.

USE OF WATER Irrigation Temp. °F. 19

SOURCE OF INFORMATION GR-4085

DRILLER or DIGGER Dickerson

ADDITIONAL DATA:

Log (NA) Water Level Measurements Chemical Analysis Aquifer Test

REMARKS: