

STATE ENGINEER  
Salem, Oregon

# Well Record

STATE WELL NO. 17/4W-1-N  
COUNTY Lane  
APPLICATION NO. GR-3706

11675

OWNER: Noah E. Glass


MAILING ADDRESS: 601 Wilkes Drive

LOCATION OF WELL: Owner's No. # 2

CITY AND STATE: Eugene, Oregon

SW 1/4 SW 1/4 Sec. 1 T. 17 N. S., R. 4 E. W., W.M.

Bearing and distance from section or subdivision corner 358.96 feet North and 2592.08 feet East of the NW Corner, Lawrence Poindexter DLC 52

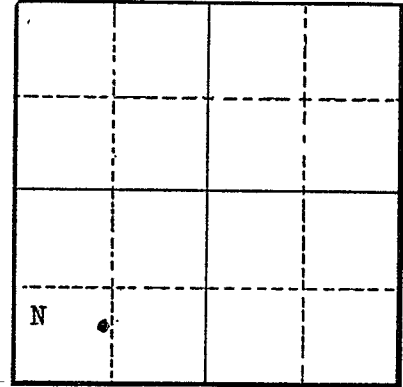

Altitude at well 360 feet

TYPE OF WELL: Driven Date Constructed 1951

Depth drilled 22 feet Depth cased

Section 1

### CASING RECORD:

### FINISH:

### AQUIFERS:

WATER LEVEL:  
not tested

PUMPING EQUIPMENT: Type Fairbanks Morse H.P.  
Capacity G.P.M.

WELL TESTS:  
Drawdown ft. after hours G.P.M.  
Drawdown ft. after hours G.P.M.

USE OF WATER Irrigation Temp. °F., 19

SOURCE OF INFORMATION GR-4086

DRILLER or DIGGER

### ADDITIONAL DATA:

Log (NA) Water Level Measurements Chemical Analysis Aquifer Test

### REMARKS:

loam	0	6
gravel	6	22