

STATE ENGINEER
Salem, Oregon

Well Record **LANE** STATE WELL NO. 17/4W-10
COUNTY LANE
APPLICATION NO. GR-2369

OWNER: Lester Beat


MAILING ADDRESS: 55 Delay Drive,

LOCATION OF WELL: Owner's No. _____

CITY AND STATE: Eugene, Oregon

SW 1/4 SE 1/4 Sec. 1 T. 17 S., R. 4 W., W.M.

Bearing and distance from section or subdivision corner 200' N. & 1480' W.

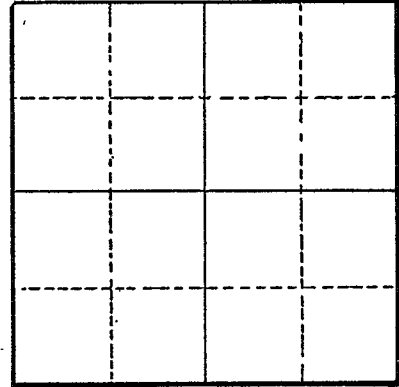

Section _____

Altitude at well _____

TYPE OF WELL: Driven Date Constructed 1954

Depth drilled 22 Depth cased 20

CASING RECORD:

4-inch

FINISH:

Perforated from 17 to 20

AQUIFERS:

WATER LEVEL:

12-feet

PUMPING EQUIPMENT: Type Fairbanks Morse H.P. 10
Capacity 300 G.P.M.

WELL TESTS:

Drawdown _____ ft. after _____ hours _____ G.P.M.
Drawdown _____ ft. after _____ hours _____ G.P.M.

USE OF WATER Irrigation Temp. _____ °F., 19

SOURCE OF INFORMATION GR-2250

DRILLER or DIGGER D. D. Dickinson, 1280 River Road, Eugene, Oregon

ADDITIONAL DATA:

Log _____ Water Level Measurements _____ Chemical Analysis _____ Aquifer Test _____

REMARKS: