

STATE ENGINEER  
Salem, Oregon

Well Record **LANE** STATE WELL NO. 17/4W-1Q(1)  
COUNTY Lane  
APPLICATION NO. GR-1063

GR- 1025

11629

OWNER: Robert D. Maclay


MAILING ADDRESS: 1250 River Loop

LOCATION OF WELL: Owner's No. #2

CITY AND STATE: Eugene, Oregon

SW 1/4 SE 1/4 Sec. 1 T. 17 S., R. 4 W., W.M.

Bearing and distance from section or subdivision  
corner 1800' S. & 80' W. from NE cor. of the  
Poindexter D.I.G. #57.

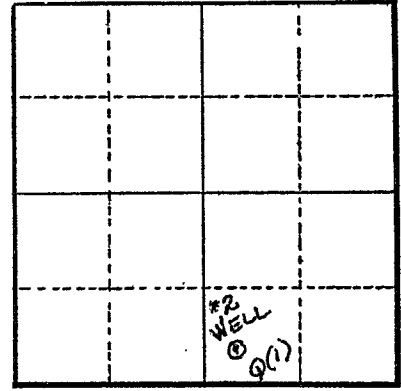

Section 1

Altitude at well 200 ft.

TYPE OF WELL: Driven Date Constructed 1940

Depth drilled 20 ft. Depth cased 20 ft.

CASING RECORD:

2 1/2 inch

FINISH:

AQUIFERS:

WATER LEVEL:

10 ft.

PUMPING EQUIPMENT: Type Cent. H.P. 5  
Capacity \_\_\_\_\_ G.P.M.

WELL TESTS:

Drawdown \_\_\_\_\_ ft. after \_\_\_\_\_ hours \_\_\_\_\_ G.P.M.  
Drawdown \_\_\_\_\_ ft. after \_\_\_\_\_ hours \_\_\_\_\_ G.P.M.

USE OF WATER Irrigation Temp. \_\_\_\_\_ °F., 19\_\_\_\_\_

SOURCE OF INFORMATION G.R. Record

DRILLER or DIGGER \_\_\_\_\_

ADDITIONAL DATA:

Log N.A. Water Level Measurements \_\_\_\_\_ Chemical Analysis \_\_\_\_\_ Aquifer Test \_\_\_\_\_

REMARKS:

Irrigation of 8.2 acres.