

STATE ENGINEER
Salem, Oregon

Well Record

STATE WELL NO. 17/4W-1R
COUNTY Lane
APPLICATION NO. CR-3546

11630

OWNER: Edward J. Thenell


MAILING ADDRESS: Chapman Drive

LOCATION OF WELL: Owner's No. _____

CITY AND STATE: Eugene, Oregon

SE 1/4 SE 1/4 Sec. 1 T. 17 S., R. 4 W., W.M.

Bearing and distance from section or subdivision
corner 1198.78 Ft. S. and 1174 ft. E. of D.L.C.
corner of D.L.C. #57

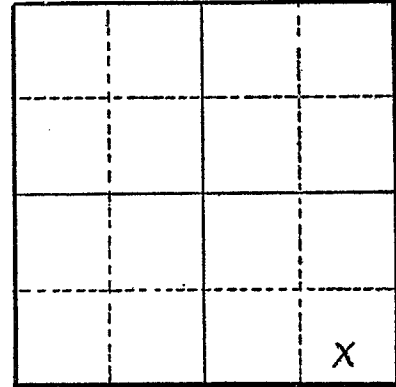

Section 1

Altitude at well _____

TYPE OF WELL: Driven Date Constructed 1940

Depth drilled 20 ft. Depth cased 20 ft.

CASING RECORD:

5 inch ? set to 20 ft.

FINISH:

AQUIFERS:

WATER LEVEL:

9 ft. below surface

PUMPING EQUIPMENT: Type Fairbanks Morse electric H.P. 5
Capacity 200 G.P.M.

WELL TESTS:

Drawdown _____ ft. after _____ hours _____ G.P.M.
Drawdown _____ ft. after _____ hours _____ G.P.M.

USE OF WATER Irrigation Temp. _____ °F., 19 _____

SOURCE OF INFORMATION Well Registration Statement

DRILLER or DIGGER _____

ADDITIONAL DATA:

Log _____ Water Level Measurements _____ Chemical Analysis _____ Aquifer Test _____

REMARKS: