

STATE ENGINEER
Salem, Oregon

Well Record **LANE** STATE WELL NO. 17/4W-2B
COUNTY Lane
APPLICATION NO. GR-3087

OWNER: Ralph M. Van Kirk


MAILING ADDRESS: 355 Spring Creek Drive

LOCATION OF WELL: Owner's No. _____

CITY AND STATE: Eugene, Oregon

NW 1/4 NE 1/4 Sec. 2 T. 17 N. S., R. 4 E. W., W.M.

Bearing and distance from section or subdivision corner 200' S. 1550' W. 669' S. 10' 8" W.

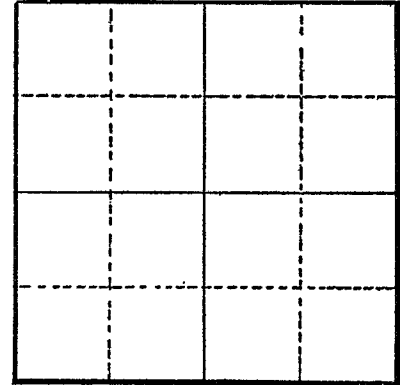

Section _____

Altitude at well _____

TYPE OF WELL: Drilled Date Constructed 1955

Depth drilled 20 feet Depth cased 20 feet

CASING RECORD:

4-inch

FINISH:

AQUIFERS:

Topsoil and gravel

WATER LEVEL:

PUMPING EQUIPMENT: Type Cornell 2-inch intake 1 1/2-inch output H.P. 5
Capacity 100 G.P.M.

WELL TESTS:

Drawdown _____ ft. after _____ hours Pumping 100 G.P.M.
Drawdown _____ ft. after _____ hours _____ G.P.M.

USE OF WATER Irrigation Temp. _____ °F., 19

SOURCE OF INFORMATION GR-2890

DRILLER or DIGGER _____

ADDITIONAL DATA:

Log x Water Level Measurements _____ Chemical Analysis _____ Aquifer Test _____

REMARKS:

Topsoil 4 20
Gravel 16