

STATE ENGINEER
Salem, Oregon

Well Record **LANE** STATE WELL NO. 17/4W-2B
COUNTY LANE
APPLICATION NO. GR-2838

OWNER: Chris Reid

MAILING ADDRESS: 401 Spring Creek Dr.

LOCATION OF WELL: Owner's No. _____

CITY AND STATE: Eugene, Oregon


NW 1/4 NE 1/4 Sec. 2 T. 17 ^{N.} S., R. 4 ^{E.} W., W.M.

Bearing and distance from section or subdivision corner _____

Altitude at well _____

TYPE OF WELL: driven Date Constructed 1950

Depth drilled 20 Depth cased 20

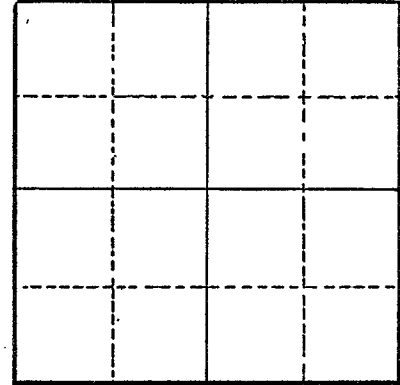

Section _____

CASING RECORD:

2 1/2-inch

FINISH:

1/4" holes distance 3' from 17 to 20

AQUIFERS:

WATER LEVEL:

12-feet

PUMPING EQUIPMENT: Type Jacuzzi Centrifugal H.P. _____
Capacity 150 G.P.M.

WELL TESTS:

Drawdown _____ ft. after _____ hours _____ G.P.M.
Drawdown _____ ft. after _____ hours _____ G.P.M.

USE OF WATER irrigation Temp. _____ °F. _____, 19____

SOURCE OF INFORMATION GR-2674

DRILLER or DIGGER Owner

ADDITIONAL DATA:

Log _____ Water Level Measurements _____ Chemical Analysis _____ Aquifer Test _____

REMARKS: