


STATE ENGINEER
Salem, Oregon

Well Record **LANE** STATE WELL NO. 17/4W-2G
11657 COUNTY LANE APPLICATION NO. GR-2379

OWNER: Fred E. and Rose A. Crutchley MAILING ADDRESS: 450 Spring Creek Drive
CITY AND STATE: Eugene, Oregon

LOCATION OF WELL: Owner's No. SW 1/4 NE 1/4 Sec. 2 T. 17 S., R. 4 W., W.M.
Bearing and distance from section or subdivision corner 1105' N. and 1436.5' W.

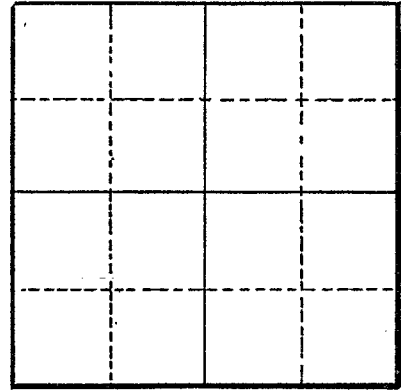

Section

Altitude at well
TYPE OF WELL: Driven Date Constructed 1954
Depth drilled 20 Depth cased 20

CASING RECORD:

3 1/2-inch

FINISH:

Slotted from 17 to 20

AQUIFERS:

Loam, sand and gravel

WATER LEVEL:

16-feet

PUMPING EQUIPMENT: Type Centrifugal H.P. 5 1/4
Capacity 60 G.P.M.

WELL TESTS:

Drawdown 3 ft. after hours Pumping 55 G.P.M.
Drawdown ft. after hours G.P.M.

USE OF WATER Irrigation Temp. °F., 19

SOURCE OF INFORMATION GR-2261
DRILLER or DIGGER

ADDITIONAL DATA:

Log X Water Level Measurements Chemical Analysis Aquifer Test

REMARKS:

Earth Sandy loam 12 12
Gravel and Sand 6 20