

STATE ENGINEER
Salem, Oregon

Well Record **LANE** STATE WELL NO. 17/LW-2A
COUNTY Lane
APPLICATION NO. GR-3090

OWNER: M. N. McNett and Betty McNett


MAILING ADDRESS: 4400 Scenic Drive

LOCATION OF WELL: Owner's No.

CITY AND STATE: Eugene, Oregon

NE 1/4 NE 1/4 Sec. 2 T. 17 N. S., R. 4 E. W., W.M.

Bearing and distance from section or subdivision corner 363' S. and 256' E.

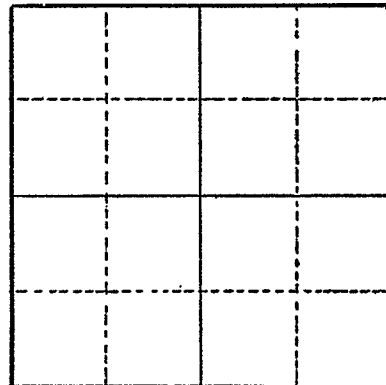

Section

Altitude at well

TYPE OF WELL: Driven Date Constructed 1947

Depth drilled 23 feet Depth cased 21 feet

CASING RECORD:

2 1/2-inch

FINISH:

AQUIFERS:

WATER LEVEL:

15 feet

PUMPING EQUIPMENT: Type Cent. 1 1/2

H.P. 5

Capacity 70 G.P.M.

WELL TESTS:

Drawdown ft. after hours G.P.M.

Drawdown ft. after hours G.P.M.

USE OF WATER Irrigation Temp. °F., 19

SOURCE OF INFORMATION GR-2893

DRILLER or DIGGER M. N. McNett

ADDITIONAL DATA:

Log Water Level Measurements Chemical Analysis Aquifer Test

REMARKS: