

STATE ENGINEER  
Salem, Oregon

Well Record **LANE** STATE WELL NO. 17/LW-2A  
11668 COUNTY LANE  
~~APPLICATION NO.~~ GR-2972

OWNER: Arthur T. Moses


MAILING ADDRESS: 4320 Scenic Drive

LOCATION OF WELL: Owner's No.

CITY AND STATE: Eugene, Oregon

NE 1/4 NE 1/4 Sec. 2 T. 17 ~~N.~~ ~~E.~~ S., R. 4 W., W.M.

Bearing and distance from section or subdivision corner 695' S. and 330' E.

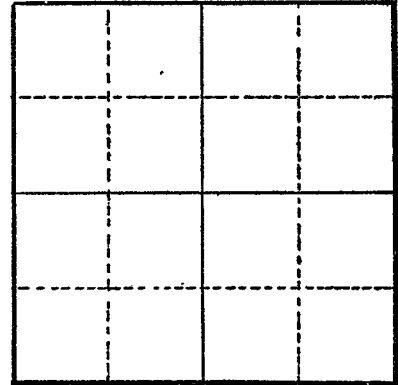

Section

Altitude at well

TYPE OF WELL: drilled Date Constructed 1949

Depth drilled 19 Depth cased 19

CASING RECORD:

2 1/2-inch

FINISH:

AQUIFERS:

WATER LEVEL:  
17-feet

PUMPING EQUIPMENT: Type Centrifugal H.P. 5  
Capacity 70 G.P.M.

WELL TESTS:

Drawdown ft. after hours G.P.M.  
Drawdown ft. after hours G.P.M.

USE OF WATER irrigation Temp. °F., 19

SOURCE OF INFORMATION GR-2786

DRILLER or DIGGER

ADDITIONAL DATA:

Log Water Level Measurements Chemical Analysis Aquifer Test

REMARKS: