

STATE ENGINEER
Salem, Oregon

Well Record **LANE** STATE WELL NO. **17/4W - 2K**
11675 COUNTY **LANE**
APPLICATION NO: **GR-2134**


OWNER: William V. Chapman & I. Lula M. Chapman

MAILING ADDRESS: 3715 River Road
CITY AND STATE: Eugene, Oregon

LOCATION OF WELL: Owner's No. _____

NW 1/4 SE 1/4 Sec. 2 T. 17 S., R. 4 W., W.M.

Bearing and distance from section or subdivision corner 1109' W. and 285' S.

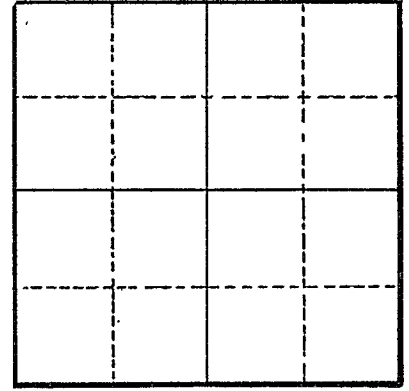

Section _____

Altitude at well _____

TYPE OF WELL: Driven Date Constructed 1936

Depth drilled 24 Depth cased _____

CASING RECORD:

FINISH:

AQUIFERS:

Loam and gravel

WATER LEVEL:

10-feet

PUMPING EQUIPMENT: Type Pacific Centrifugal H.P. 3
Capacity 90 G.P.M.

WELL TESTS:

Drawdown _____ ft. after _____ hours Pumping 85 G.P.M.
Drawdown _____ ft. after _____ hours _____ G.P.M.

USE OF WATER Irrigation Temp. _____ °F., 19 _____

SOURCE OF INFORMATION GR-2047

DRILLER or DIGGER _____

ADDITIONAL DATA:

Log X Water Level Measurements _____ Chemical Analysis _____ Aquifer Test _____

REMARKS:

Loam for first 8
Gravel for balance 16