

STATE ENGINEER
Salem, Oregon


Well Record

LANE STATE WELL NO. 17/4W-2L
11/6/76 COUNTY LANE
APPLICATION NO. GR-2332

OWNER: Jess G. White or Caroline E. White MAILING ADDRESS: 3850 River Road

LOCATION OF WELL: Owner's No. CITY AND STATE: Eugene, Oregon

NE 1/4 SW 1/4 Sec. 2 T. 17 S., R. 4 W., W.M.
Bearing and distance from section or subdivision
corner 190' E. and 20' N. from SW corner Lot
of Thompsons Flat

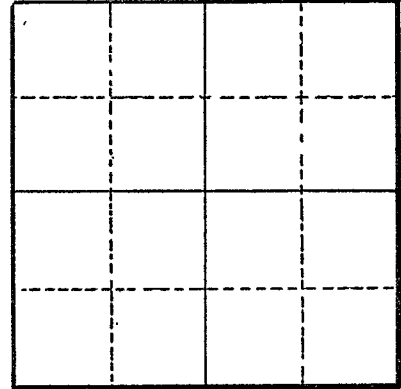

Section

Altitude at well

TYPE OF WELL: Driven Date Constructed 1940

Depth drilled 18 Depth cased

CASING RECORD:

FINISH:

AQUIFERS:

WATER LEVEL: 8-feet

PUMPING EQUIPMENT: Type Myers Centrifugal H.P. 3/4
Capacity 20 G.P.M.

WELL TESTS:
Drawdown ft. after hours G.P.M.
Drawdown ft. after hours G.P.M.

USE OF WATER Irrigation Temp. °F., 19

SOURCE OF INFORMATION GR-2218
DRILLER or DIGGER Owen Thompson, 1060 Polk Eugene, Oregon

ADDITIONAL DATA:
Log Water Level Measurements Chemical Analysis Aquifer Test

REMARKS: