

STATE ENGINEER
Salem, Oregon

Well Record **LANE** STATE WELL NO. 17/4W-2L(1)
COUNTY Lane
APPLICATION NO. GR-414

OWNER: Arthur A. Guthrie


MAILING ADDRESS: 3910 River Road

LOCATION OF WELL: Owner's No.

CITY AND STATE: Eugene, Oregon

NE 1/4 SW 1/4 Sec. 2 T. 17 N. S., R. 4 E. W., W.M.

Bearing and distance from section or subdivision
corner 2572' N. 69° 32' E. from SW cor. T. S.
Poindexter DLC

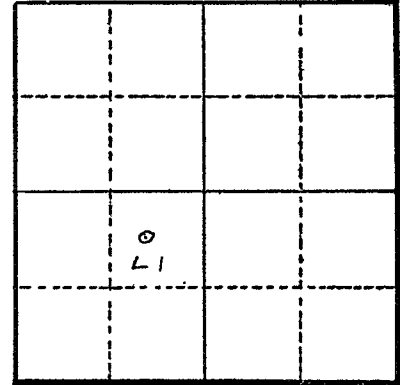

Altitude at well 375

TYPE OF WELL: Dug Date Constructed 1937

Depth drilled 20 Depth cased 18

Section 2

CASING RECORD:

60 inch

FINISH:

AQUIFERS:

WATER LEVEL:

10

PUMPING EQUIPMENT: Type Centrifugal H.P. 10 & 5
Capacity 250 & 120 G.P.M.

WELL TESTS:

Drawdown ft. after hours G.P.M.
Drawdown ft. after hours G.P.M.

USE OF WATER Irrigation 30 Temp. °F., 19

SOURCE OF INFORMATION GR-414

DRILLER or DIGGER Hired man of owner

ADDITIONAL DATA:

Log Water Level Measurements Chemical Analysis Aquifer Test

REMARKS:

Log
Loam 0 to 8
Gravel 8 to 20