

STATE ENGINEER
Salem, Oregon

Well Record **LANE** STATE WELL NO. 17/4W-2L(1)
COUNTY Lane
APPLICATION NO. GR-376

OWNER: Melvin L. Thompson


MAILING ADDRESS: 3910 River Road

LOCATION OF WELL: Owner's No.

CITY AND STATE: Eugene, Oregon

NE 1/4 SW 1/4 Sec. 2 T. 17 N. R. 4 E. W.M.

Bearing and distance from section or subdivision
corner 2210' N. 80° 18' E. from SW corner
T. S. Poindexter DLC

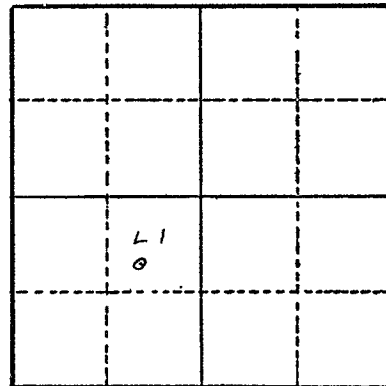

Section 2

Altitude at well 375

TYPE OF WELL: Driven Date Constructed 1942

Depth drilled 20 Depth cased 20

CASING RECORD:

2 inch

FINISH:

AQUIFERS:

WATER LEVEL:

10 feet

PUMPING EQUIPMENT: Type Berkeley 2 1/2 centrifugal H.P. 15
Capacity 270 G.P.M.

WELL TESTS:

Drawdown ft. after hours G.P.M.
Drawdown ft. after hours G.P.M.

USE OF WATER Irrigation 30 acres Temp. °F. 19

SOURCE OF INFORMATION GR-376

DRILLER or DIGGER Owner

ADDITIONAL DATA:

Log Water Level Measurements Chemical Analysis Aquifer Test

REMARKS:

Log

Loam 0 to 8
River gravel 8 to 20