

STATE ENGINEER
Salem, Oregon

Well Record **LANE** STATE WELL NO. 17/4W-2N
COUNTY Lane
11683 APPLICATION NO. GR-3908

OWNER: William A. Revell


MAILING ADDRESS: 555 Irvington Drive

LOCATION OF WELL: Owner's No. _____

CITY AND STATE: Eugene, Oregon

SW 1/4 SW 1/4 Sec. 2 T. 17 S., R. 4 W., W.M.

Bearing and distance from section or subdivision corner 1050' N. & 1060' E. of SW Cor. Sec. 2

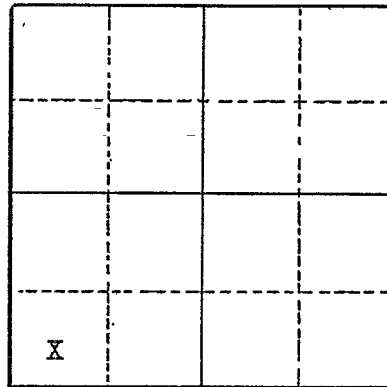

Altitude at well _____

TYPE OF WELL: Driven Date Constructed 1946

Depth drilled 20 feet Depth cased 20 feet

Section 2

CASING RECORD:

2 1/2 inch casing driven to 20 feet

FINISH:

Drilled holes from 17 to 20 feet

AQUIFERS:

WATER LEVEL:

15 feet below surface

PUMPING EQUIPMENT: Type Berkeley centrifugal H.P. 2
Capacity 100 G.P.M.

WELL TESTS:

Drawdown _____ ft. after _____ hours _____ G.P.M.

Drawdown _____ ft. after _____ hours _____ G.P.M.

USE OF WATER Irrigation Temp. _____ °F., 19 _____

SOURCE OF INFORMATION Well Registration Statement Cert. # GR-3548

DRILLER or DIGGER William A. Revell

ADDITIONAL DATA:

Log _____ Water Level Measurements _____ Chemical Analysis _____ Aquifer Test _____

REMARKS: