

STATE ENGINEER
Salem, Oregon

Well Record

STATE WELL NO. 17/4W-2R
COUNTY Lane
APPLICATION NO. GR-2689

11691

OWNER: Matt J. Eberle

MAILING ADDRESS: 38 Wilkes Drive


LOCATION OF WELL: Owner's No.

CITY AND STATE: Eugene, Oregon

SE 1/4 SE 1/4 Sec. 2 T. 17 N. S. R. 4 W., W.M.

Bearing and distance from section or subdivision

corner 330' N. & 40' W.

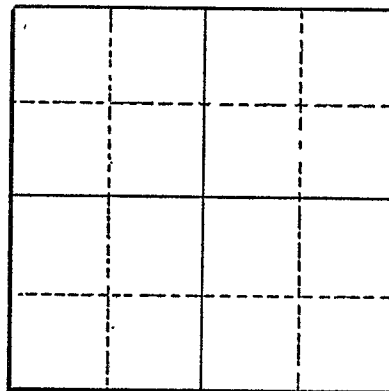

Section

Altitude at well

TYPE OF WELL: Driven Date Constructed 1938

Depth drilled 20' Depth cased 20'

CASING RECORD:

3 inch

FINISH:

AQUIFERS:

WATER LEVEL:

10 feet

PUMPING EQUIPMENT: Type Allis Chalmers Centrifugal H.P. 3
Capacity 80 G.P.M.

WELL TESTS:

Drawdown ft. after hours G.P.M.

Drawdown ft. after hours G.P.M.

USE OF WATER irrigation Temp. °F. 19

SOURCE OF INFORMATION GR-2547

DRILLER or DIGGER

ADDITIONAL DATA:

Log Water Level Measurements Chemical Analysis Aquifer Test

REMARKS: