

STATE ENGINEER
Salem, Oregon

Well Record

LANE
11704

STATE WELL NO. 17/LW-3A
COUNTY Lane
APPLICATION NO. GR-2709

OWNER: Helen Bell Larson


MAILING ADDRESS: 555 Buena Vista W.

LOCATION OF WELL: Owner's No. #3

CITY AND STATE: San Francisco 17, California

NE 1/4 NE 1/4 Sec. 3 T. 17 S., R. 4 W., W.M.

Bearing and distance from section or subdivision
corner 812 ft. E. and 446 ft. N. of SW corner
James Watson DLC 47

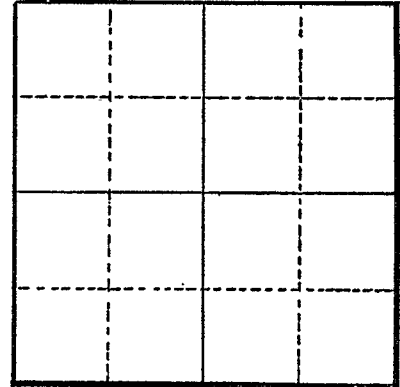

Section

Altitude at well

TYPE OF WELL: Drilled Date Constructed 1952

Depth drilled 80 feet Depth cased 80 feet

CASING RECORD:

8-inch intake

FINISH:

AQUIFERS:

WATER LEVEL:

15 feet

PUMPING EQUIPMENT: Type Pomona Wesco Turbine H.P. 30
Capacity 400 G.P.M.

WELL TESTS:

Drawdown ft. after hours Pumping 400 G.P.M.
Drawdown ft. after hours G.P.M.

USE OF WATER Irrigation Temp. °F., 19

SOURCE OF INFORMATION GR-2858

DRILLER or DIGGER

ADDITIONAL DATA:

Log Water Level Measurements Chemical Analysis Aquifer Test

REMARKS: