

STATE ENGINEER
Salem, Oregon

Well Record **LANE** STATE WELL NO. 17/LW-3D
COUNTY Lane
11:708 APPLICATION NO. GR-2710

OWNER: Helen Bell Larson

MAILING ADDRESS: 555 Buena Vista West


LOCATION OF WELL: Owner's No. #1

CITY AND STATE: San Francisco 17, California

NW 1/4 NW 1/4 Sec. 3 T. 17 S., R. 4 W., W.M.

Bearing and distance from section or subdivision

corner 1088' E. and 540' N. of SW Corner James
Watson DLC 47

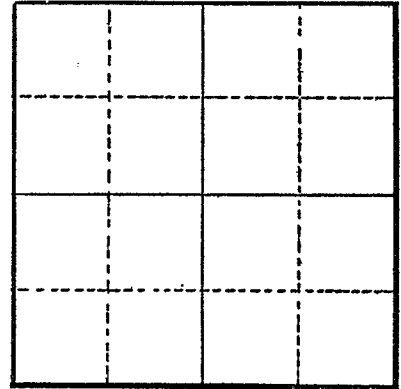

Section

Altitude at well

TYPE OF WELL: Driven Date Constructed 1946

Depth drilled 20' Depth cased 20'

CASING RECORD:

4"

FINISH:

slotted 17 to 20

AQUIFERS:

WATER LEVEL:

15'

PUMPING EQUIPMENT: Type Cent 4" x 3" outlet H.P. 15
Capacity 340 G.P.M.

WELL TESTS:

Drawdown ft. after hours pumping 340 G.P.M.

Drawdown ft. after hours G.P.M.

USE OF WATER Irrigation and stock Temp. °F., 19

SOURCE OF INFORMATION GR-2859

DRILLER or DIGGER

ADDITIONAL DATA:

Log Water Level Measurements Chemical Analysis Aquifer Test

REMARKS: