

STATE ENGINEER
Salem, Oregon

Well Record **LANE** STATE WELL NO. 17/4W-3J
COUNTY **LANE**
APPLICATION NO. GR-2056
11709

OWNER: Lawrence or Louise Szukai


MAILING ADDRESS: Rt 1, Box 75

LOCATION OF WELL: Owner's No.

CITY AND STATE: Eugene, Oregon

NE 1/4 SE 1/4 Sec. e T. 17 S., R. 4 W., W.M.

Bearing and distance from section or subdivision corner 66' S & 97' W of donation land claim corner

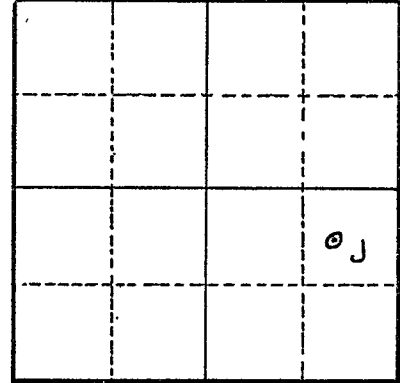

Section 3

Altitude at well

TYPE OF WELL: Driven Date Constructed 1928

Depth drilled 19' Depth cased

CASING RECORD:

FINISH:

AQUIFERS:

WATER LEVEL:

12'

PUMPING EQUIPMENT: Type Carver Centrifugal H.P. 1 3/4
Capacity 3000 G.P.M.

WELL TESTS:

Drawdown 1 1/2 ft. after 3000 hours G.P.M.
Drawdown ft. after hours G.P.M.

USE OF WATER Irrigation Temp. °F., 19

SOURCE OF INFORMATION GR-3844

DRILLER or DIGGER NA

ADDITIONAL DATA:

Log NA Water Level Measurements Chemical Analysis Aquifer Test

REMARKS: