

STATE ENGINEER
Salem, Oregon

Well Record **LANE** STATE WELL NO. 17/4W-3L
COUNTY Lane
APPLICATION NO. GR-4265

OWNER: Gordon W. Elliott


MAILING ADDRESS: 938 Jefferson Street

LOCATION OF WELL: Owner's No. 1

CITY AND STATE: Eugene, Oregon

NE 1/4 SW 1/4 Sec. 3 T. 17 S., R. 4 W., W.M.

Bearing and distance from section or subdivision corner 825 feet West and 690 feet South from center of Section 3.

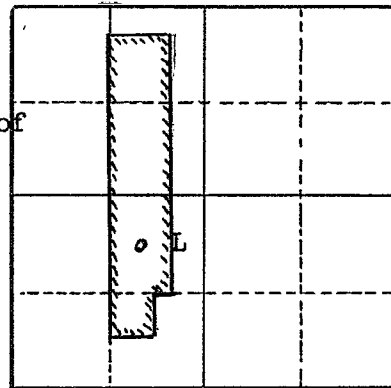

Altitude at well 365 feet

TYPE OF WELL: Drilled Date Constructed April 1952

Depth drilled 114 feet Depth cased 110 feet

Section 3

CASING RECORD:

8-inch steel casing set from 0 to 110 feet

FINISH:

110' of 8" perforated casing

AQUIFERS:

WATER LEVEL:

12 feet

PUMPING EQUIPMENT: Type Jacuzzi Lineshaft Turbine H.P. _____
Capacity 390 G.P.M.

WELL TESTS:

Drawdown 92 ft. after _____ hours 440 G.P.M.

Drawdown _____ ft. after _____ hours _____ G.P.M.

USE OF WATER Irrigation Temp. _____ °F., 19 _____

SOURCE OF INFORMATION GR-4116

DRILLER or DIGGER _____

ADDITIONAL DATA:

Log (NA) Water Level Measurements _____ Chemical Analysis _____ Aquifer Test _____

REMARKS: