

STATE ENGINEER
Salem, Oregon


Well Record **LANE** STATE WELL NO. 17/4W-3P
COUNTY Lane
APPLICATION NO. GR-4266

11711

OWNER: Gordon W. Elliott MAILING ADDRESS: 938 Jefferson Street

LOCATION OF WELL: Owner's No. 2 CITY AND STATE: Eugene, Oregon

SE 1/4 SW 1/4 Sec. 3 T. 17 N. S. R. 4 W., W.M.
Bearing and distance from section or subdivision corner 660 feet West and 1730 feet South of center of Section 3.

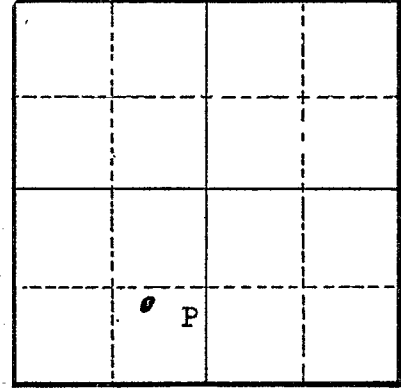

Section 3

Altitude at well 365 feet

TYPE OF WELL: Drilled Date Constructed 1944

Depth drilled 40 feet Depth cased

CASING RECORD:

FINISH:

AQUIFERS:

WATER LEVEL:

PUMPING EQUIPMENT: Type Myers Ejecto H.P.
Capacity 15 G.P.M.

WELL TESTS:
Drawdown ft. after hours G.P.M.
Drawdown ft. after hours G.P.M.

USE OF WATER Irrigation Temp. °F., 19
SOURCE OF INFORMATION GR-4117

DRILLER or DIGGER

ADDITIONAL DATA:
Log (NA) Water Level Measurements Chemical Analysis Aquifer Test

REMARKS: