


STATE ENGINEER  
Salem, Oregon

Well Record **LANE** STATE WELL NO. 17/LW-3 R.  
COUNTY **LANE**  
APPLICATION NO. GR-3196  
**11716**

OWNER: Willard J. & Gladys L. Swenson MAILING ADDRESS: Rt 1, Box 74  
CITY AND STATE: Eugene, Oregon

LOCATION OF WELL: Owner's No. \_\_\_\_\_  
SE 1/4 SE 1/4 Sec. 3 T. 17 S., R. 4 W., W.M.  
Bearing and distance from section or subdivision  
corner 850' W & 980' N from SE Cor Sec 3

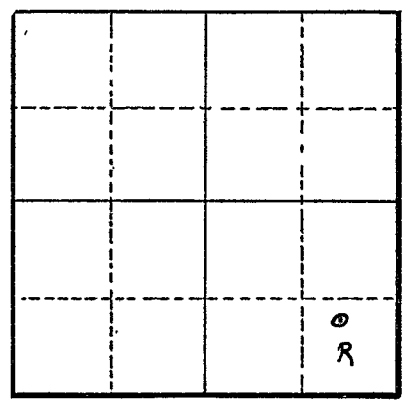

Section 3

Altitude at well \_\_\_\_\_

TYPE OF WELL: Drove Date Constructed 1949  
Depth drilled 20' Depth cased 20'

CASING RECORD:  
3-inch

FINISH:  
slotted

AQUIFERS:

WATER LEVEL:  
15'

PUMPING EQUIPMENT: Type Ingersoll-Rand H.P. 3  
Capacity 100 G.P.M.

WELL TESTS:  
Drawdown \_\_\_\_\_ ft. after \_\_\_\_\_ hours \_\_\_\_\_ G.P.M.  
Drawdown \_\_\_\_\_ ft. after \_\_\_\_\_ hours \_\_\_\_\_ G.P.M.

USE OF WATER Irrigation Temp. \_\_\_\_\_ °F., 19\_\_\_\_

SOURCE OF INFORMATION GR-3928  
DRILLER or DIGGER Miller-Jenson Co.

ADDITIONAL DATA:  
Log NA Water Level Measurements \_\_\_\_\_ Chemical Analysis \_\_\_\_\_ Aquifer Test \_\_\_\_\_

REMARKS: