

STATE ENGINEER
Salem, Oregon

Well Record

STATE WELL NO. 17/4W-4H
COUNTY Lane
APPLICATION NO. GR-2359


LANE
11746

OWNER: Harry Neil & Martha Beth Christensen MAILING ADDRESS: Rt. 1, Box 171

LOCATION OF WELL: Owner's No. CITY AND STATE: Eugene, Oregon

SE 1/4 NE 1/4 Sec. 4 T. 17 S., R. 4 W., W.M.

Bearing and distance from section or subdivision corner 1530' E., then 285' N.

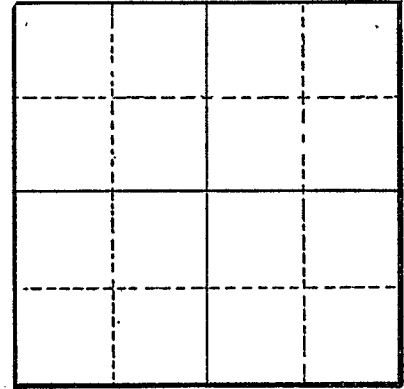

Section

Altitude at well

TYPE OF WELL: Driven Date Constructed 1947

Depth drilled 26 Depth cased 26

CASING RECORD:

3-inch

FINISH:

Perforations from 23 to 26

AQUIFERS:

Sand and gravel

WATER LEVEL:

2' to 7'

PUMPING EQUIPMENT: Type Jacuzzi 3 stage H.P. 1
Capacity 40 G.P.M.

WELL TESTS:
Drawdown 2 ft. after hours Pumping 60 G.P.M.
Drawdown ft. after hours G.P.M.

USE OF WATER Irrigation Temp. °F., 19

SOURCE OF INFORMATION GR-2241

DRILLER or DIGGER

ADDITIONAL DATA:
Log Water Level Measurements Chemical Analysis Aquifer Test

REMARKS:

	Topsoil of 2 1/2"		
Poor second River bottom soil	6 1/2' of shore clay base	9'	17'
Heavy gumming - clay hardpan		6'	11'
Sand-Gravel-etc., Water Bearing strata		11'	on Bottom
	Total	26'	