

STATE ENGINEER  
Salem, Oregon

# Well Record


LANE  
11757  
STATE WELL NO. 17/4W-5A  
COUNTY Lane  
APPLICATION NO. CR-3643

OWNER: Clavert R. Loe  
MAILING ADDRESS: 3230 Bell Ave.

LOCATION OF WELL: Owner's No. \_\_\_\_\_  
CITY AND STATE: Eugene, Oregon

NE 1/4 SW 1/4 Sec. 5 T. 17 S. R. 4 W., W.M.

Bearing and distance from section or subdivision  
corner 250' S. of the N. line & 250' W. of the E line

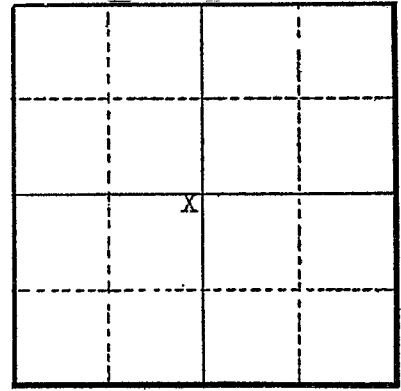

Section 5

Altitude at well \_\_\_\_\_

TYPE OF WELL: driven Date Constructed Oct., 1953

Depth drilled 21 feet Depth cased 20 feet

### CASING RECORD:

6 inch casing set to 20 feet

### FINISH:

### AQUIFERS:

### WATER LEVEL:

15 feet below surface

PUMPING EQUIPMENT: Type Berkeley Centrifugal H.P. 5  
Capacity 340 G.P.M.

### WELL TESTS:

Drawdown \_\_\_\_\_ ft. after \_\_\_\_\_ hours 180 G.P.M.  
Drawdown \_\_\_\_\_ ft. after \_\_\_\_\_ hours \_\_\_\_\_ G.P.M.

USE OF WATER Irrigation Temp. °F. \_\_\_\_\_, 19

SOURCE OF INFORMATION Well Registration Statement

DRILLER or DIGGER Myers Brothers

### ADDITIONAL DATA:

Log  Water Level Measurements \_\_\_\_\_ Chemical Analysis \_\_\_\_\_ Aquifer Test \_\_\_\_\_

### REMARKS:

Log:  
Top soil  
Hard pan  
sand & gravel

Thickness	Depth to Bottom
2	17
2	15
15	0