


STATE ENGINEER  
Salem, Oregon

Well Record **LANE** STATE WELL NO. 17/4W-5R  
11765 COUNTY Lane  
APPLICATION NO. GR-3564

OWNER: Frank N. Savage MAILING ADDRESS: Route 1, Box 196B

LOCATION OF WELL: Owner's No. CITY AND STATE: Eugene, Oregon

NE 1/4 SE 1/4 Sec. 5 T. 17 S., R. 4 W., W.M.  
Bearing and distance from section or subdivision  
corner 1165 ft. N. of the SE corner of Sec. 5  
and 66 ft. W. of the W. line of Enid Station Rd.

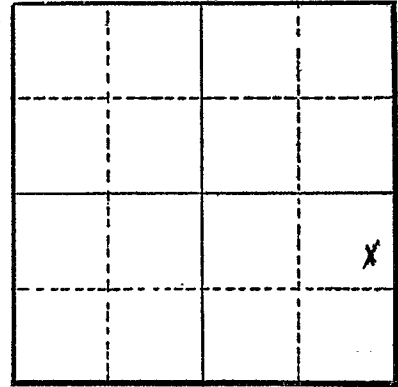

Section 5

Altitude at well

TYPE OF WELL: Drilled Date Constructed Aug., 1952

Depth drilled 46 ft. Depth cased 42 ft.

CASING RECORD:

6 inch casing set to 42 feet

FINISH:

AQUIFERS:

WATER LEVEL:

10 feet below surface

PUMPING EQUIPMENT: Type Fairbanks-Morse H.P. 5  
Capacity 105 G.P.M.

WELL TESTS:

Drawdown 10 ft. after hours 105 G.P.M.  
Drawdown ft. after hours G.P.M.

USE OF WATER Irrigation Temp. °F., 19

SOURCE OF INFORMATION Well Registration Statement

DRILLER or DIGGER Curtis Miller Well Drilling Company

ADDITIONAL DATA:

Log Water Level Measurements Chemical Analysis Aquifer Test

REMARKS: