

STATE ENGINEER
Salem, Oregon

Well Record **LANE** STATE WELL NO. 17/LW-7C
1776 COUNTY LANE
APPLICATION NO. GR-2942

OWNER: Joseph R. McNaught & Jewel M. McNaught


MAILING ADDRESS: Rt. 1, Box 216

LOCATION OF WELL: Owner's No. _____

CITY AND STATE: Eugene, Oregon

NE 1/4 NW 1/4 Sec. 7 T. 17 N S., R. 4 SE W., W.M.

Bearing and distance from section or subdivision corner 320' S. & 900' W.

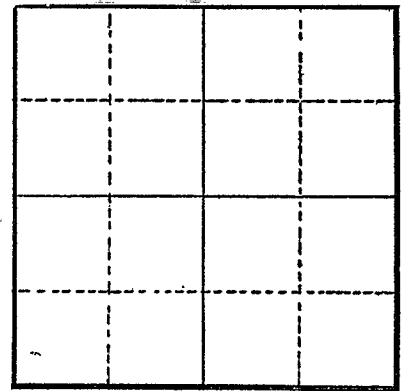

Section _____

Altitude at well _____

TYPE OF WELL: gravel pit Date Constructed _____

Depth drilled _____ Depth cased _____

CASING RECORD:

4-inch

FINISH:

AQUIFERS:

WATER LEVEL: 8-feet

PUMPING EQUIPMENT: Type Fairbanks Morse H.P. _____
Capacity 500 G.P.M.

WELL TESTS:
Drawdown _____ ft. after _____ hours Pumping 500 G.P.M.
Drawdown _____ ft. after _____ hours _____ G.P.M.

USE OF WATER irrigation Temp. _____ °F. _____, 19____

SOURCE OF INFORMATION GR-2766

DRILLER or DIGGER _____

ADDITIONAL DATA:
Log _____ Water Level Measurements _____ Chemical Analysis _____ Aquifer Test _____

REMARKS: