

STATE ENGINEER
Salem, Oregon

Well Record **LANE** STATE WELL NO. 17/LW-8D
COUNTY Lane
APPLICATION NO. GR-3384

OWNER: Elbert O. Drake


MAILING ADDRESS: Route 1, Box 213

LOCATION OF WELL: Owner's No.

CITY AND STATE: Eugene, Oregon

NW 1/4 NW 1/4 Sec. 8 T. 17 N. S., R. 4 E. W.M.

Bearing and distance from section or subdivision
corner 1070' S. and 440' E.

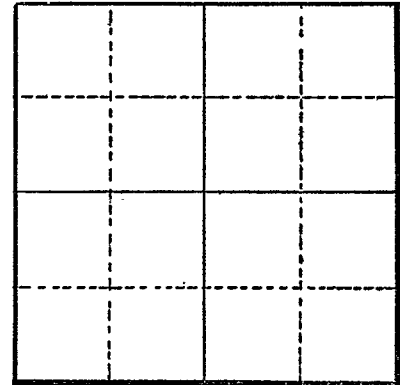

Section

Altitude at well

TYPE OF WELL: drilled Date Constructed 1952

Depth drilled 38' Depth cased 33'

CASING RECORD:

5"

FINISH:

AQUIFERS:

soil, gravel, sand

WATER LEVEL:

14'

PUMPING EQUIPMENT: Type Myers Electric & Flomax Gas H.P. 2 & 6
Capacity 70 & 110 G.P.M.

WELL TESTS:

Drawdown 2 to 3 ft. after hours pumping 150 G.P.M.

Drawdown ft. after hours G.P.M.

USE OF WATER Irrigation Temp. °F. 19

SOURCE OF INFORMATION GR-3125

DRILLER or DIGGER owner

ADDITIONAL DATA:

Log X Water Level Measurements Chemical Analysis Aquifer Test

REMARKS: Top soil 8' 30'
Pit gravel-some water at 15' 12' 18'
sand - some water 3' 15'
course gravel and sand water 15' 0'
most of this depth