

STATE ENGINEER  
Salem, Oregon

Well Record LANE STATE WELL NO. 17/4W-8P(2)  
GR- 1229 COUNTY Lane  
11793 APPLICATION NO. GR- 1273

OWNER: Clayton C. Bryan

MAILING

ADDRESS: Rt. 1, Box 642

LOCATION OF WELL: Owner's No. #2

CITY AND

STATE: Eugene, Oregon

SE  $\frac{1}{4}$  SW  $\frac{1}{4}$  Sec. 8 T. 17 S., R. 4 W., W.M.


Bearing and distance from section or subdivision

corner 912' N. & 75' W. from S $\frac{1}{4}$  cor. Sec. 8

Altitude at well 365 ft.

TYPE OF WELL: Dug Date Constructed 1954

Depth drilled 15 ft. Depth cased Open

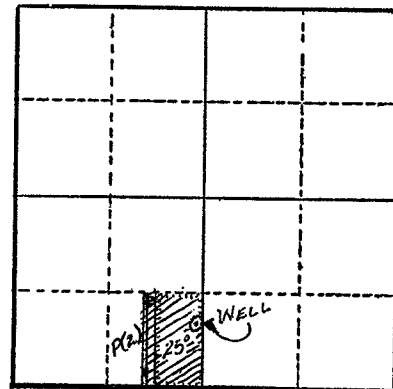

Section 8

CASING RECORD:

FINISH:

AQUIFERS:

WATER LEVEL:

4 ft.

PUMPING EQUIPMENT: Type 2 in. Cent. H.P. 7 $\frac{1}{2}$   
Capacity 200 G.P.M.

WELL TESTS:

Drawdown 10 ft. after 150 hours G.P.M.

Drawdown        ft. after        hours G.P.M.

USE OF WATER Irrigation Temp.        °F., 19

SOURCE OF INFORMATION G. R. Record

DRILLER or DIGGER       

ADDITIONAL DATA:

Log N.A. Water Level Measurements        Chemical Analysis        Aquifer Test       

REMARKS:

Irrigation of 25 acres.