

STATE ENGINEER
Salem, Oregon

Well Record

GR- 1364

STATE WELL NO. 17/4W-8R
COUNTY Lane
APPLICATION NO. GR- 1409

OWNER: L. R. Misner

MAILING

ADDRESS: Rt. 1, Box 646

LOCATION OF WELL: Owner's No.


CITY AND

STATE: Eugene, Oregon

SE $\frac{1}{4}$ SE $\frac{1}{4}$ Sec. 8 T. 17 S. R. 4 W., W.M.

Bearing and distance from section or subdivision

corner N.33°W. 1265' from SE cor. Sec. 8

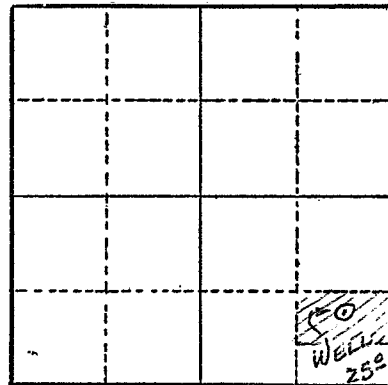

Altitude at well 325 ft.

TYPE OF WELL: Drilled Date Constructed 1949

Depth drilled 85 ft. Depth cased 63 ft.

Section 8

CASING RECORD:

8 inch

FINISH:

2 perforations per ft. ($\frac{1}{2}$ x 6 in.) from 20 to 40 ft.

AQUIFERS:

WATER LEVEL:

10 ft.

PUMPING EQUIPMENT: Type Deming $1\frac{1}{2}$ x 2 in. Cent. H.P. 5
Capacity 200 G.P.M.

WELL TESTS:

Drawdown ft. after hours G.P.M.

Drawdown ft. after hours G.P.M.

USE OF WATER Irrigation Temp. °F. 19

SOURCE OF INFORMATION G. R. Record

DRILLER or DIGGER Earl McIntosh

ADDITIONAL DATA:

Log N.A. Water Level Measurements Chemical Analysis Aquifer Test

REMARKS:

Irrigation of 25 acres.