

LANE
11815

OWNER: Mervin J. Rassow


MAILING ADDRESS:

LOCATION OF WELL: Owner's No.

CITY AND STATE: Junction City, Oregon

NE 1/4 NE 1/4 Sec. 9 T. 17 S., R. 4 W., W.M.

Bearing and distance from section or subdivision corner 50' S. & 15' W.

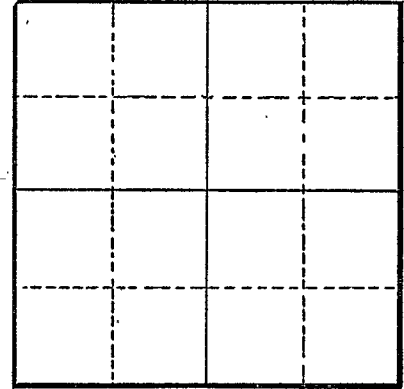

Section

Altitude at well

TYPE OF WELL: Drilled Date Constructed 1954

Depth drilled 42 Depth cased 42

CASING RECORD:

6-inch

FINISH:

Standard perforations from 38 to 42

AQUIFERS:

Loam, sand & gravel

WATER LEVEL:

20-feet

PUMPING EQUIPMENT: Type Fairbanks Morse Centrifugal H.P. 3
Capacity 70 G.P.M.

WELL TESTS:

Drawdown 34 ft. after hours Pumping 100 G.P.M.

Drawdown ft. after hours G.P.M.

USE OF WATER Irrigation Temp. °F., 19

SOURCE OF INFORMATION GR-2451

DRILLER or DIGGER

ADDITIONAL DATA:

Log X Water Level Measurements Chemical Analysis Aquifer Test

REMARKS:

Loam 3 39
Sand & Gravel 39 0