

STATE ENGINEER
Salem, Oregon

Well Record **LANE** STATE WELL NO. 17/4W-9K
GR- 1711 11817 COUNTY Lane
APPLICATION NO. GR- 1763

OWNER: Leland C. Ross


MAILING ADDRESS: Rt. 1, Box 651

LOCATION OF WELL: Owner's No.

CITY AND STATE: Eugene, Oregon

NW 1/4 SE 1/4 Sec. 9 T. 17 S., R. 4 W., W.M.

Bearing and distance from section or subdivision corner 2640' S. & 2440' W. from NE cor. Sec. 9

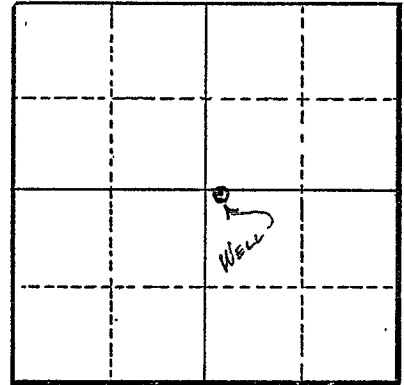

Section 9

Altitude at well

TYPE OF WELL: Dug Date Constructed 1950

Depth drilled 20' Depth cased 20' Sump

CASING RECORD:

Infiltration trench - 60' x 100' x 20'

FINISH:

AQUIFERS:

WATER LEVEL:

8'

PUMPING EQUIPMENT: Type Cornell 2 1/2" Cent. H.P. 10
Capacity 240 G.P.M.

WELL TESTS:

Drawdown ft. after hours G.P.M.
Drawdown ft. after hours G.P.M.

USE OF WATER Irrigation Temp. °F. 19

SOURCE OF INFORMATION GR Record

DRILLER or DIGGER

ADDITIONAL DATA:

Log N.A. Water Level Measurements Chemical Analysis Aquifer Test

REMARKS:

Irrigation of 34 acres.