

STATE ENGINEER  
Salem, Oregon

Well Record **LANE** STATE WELL NO. 17/4W-10A  
COUNTY Lane  
APPLICATION NO. GR-704

OWNER: Wendell P. & Evelyn M. Wick


MAILING ADDRESS: 3291 Arrowhead Dr.

LOCATION OF WELL: Owner's No. 1

CITY AND STATE: Eugene, Oregon

NE 1/4 NE 1/4 Sec. 10 T. 17 N. S. R. 4 E. W., W.M.

Bearing and distance from section or subdivision  
corner 970' W. & 600' S. from NE 1/4 Sec. 10

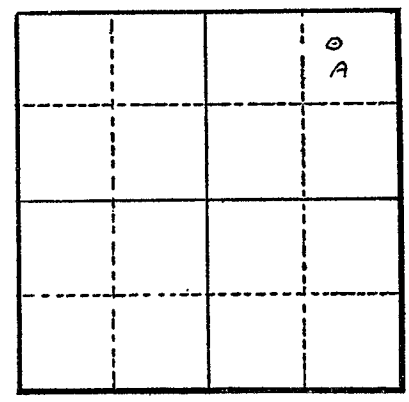

Section 10

Altitude at well 373 ft. Interpolated

TYPE OF WELL: 20' driven Date Constructed 5/15/55

Depth drilled 20 ft. Depth cased 25 ft.

CASING RECORD: 3 inch

FINISH:

AQUIFERS:

WATER LEVEL: 12 ft.

PUMPING EQUIPMENT: Type centrifugal H.P. 7 1/2  
Capacity 220 G.P.M.

WELL TESTS:  
Drawdown 17.5 ft. after 300 hours G.P.M.  
Drawdown 14 ft. after 200 hours G.P.M.

USE OF WATER irrigation 20 acres Temp. °F., 19

SOURCE OF INFORMATION GR-704

DRILLER or DIGGER

ADDITIONAL DATA:  
Log Water Level Measurements Chemical Analysis Aquifer Test

REMARKS: