

STATE ENGINEER
Salem, Oregon

Well Record

LANE
11905 STATE WELL NO. 17/4W-11D(1)
COUNTY Lane
APPLICATION NO. GR-430

OWNER: Berntzen Fruit Farm

MAILING ADDRESS: 128 Berntzen Rd., N.


LOCATION OF WELL: Owner's No. _____

CITY AND STATE: Eugene, Oregon

N. E.
NW 1/4 NW 1/4 Sec. 11 T. 17 S., R. 4 W., W.M.

Bearing and distance from section or subdivision
corner 816 ft. E. & 3012 ft. N. from SW cor.

A. A. Peck D.C. 1651

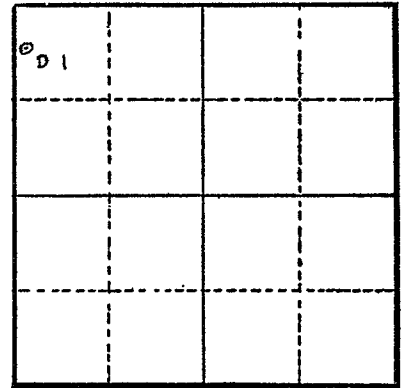

Section 11

Altitude at well 480

TYPE OF WELL: driven Date Constructed 9/20/54

Depth drilled 25 Depth cased 25

CASING RECORD: 3 inch

FINISH:

AQUIFERS:

WATER LEVEL: 10 ft.

PUMPING EQUIPMENT: Type centrifugal H.P. 7 1/2
Capacity 180 G.P.M.

WELL TESTS:
Drawdown _____ ft. after _____ hours _____ G.P.M.
Drawdown _____ ft. after _____ hours _____ G.P.M.

USE OF WATER irrigation 28 acres Temp. _____ °F. _____, 19.

SOURCE OF INFORMATION GR-430

DRILLER or DIGGER _____

ADDITIONAL DATA:

Log _____ Water Level Measurements _____ Chemical Analysis _____ Aquifer Test _____

REMARKS: