


STATE ENGINEER
Salem, Oregon

Well Record **LANE** STATE WELL NO. 17/LW-111
COUNTY Lane
APPLICATION NO. GR-3537
11919

OWNER: Herbert A. Metcalf
MAILING ADDRESS: 501 Irving Road
CITY AND STATE: Eugene, Oregon

LOCATION OF WELL: Owner's No. XX
NE 1/4 SW 1/4 Sec. 11 T. 17 S. R. 4 W., W.M.

Bearing and distance from section or subdivision corner
.....
.....
.....

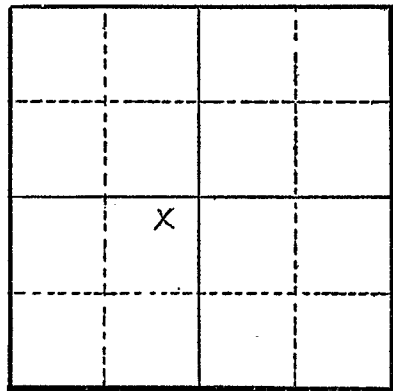

Section 11

Altitude at well

TYPE OF WELL: Dug Date Constructed 6/39

Depth drilled 20 ft. ? Depth cased

CASING RECORD:

4 x 4 cribbed 5 1/2 ft. squared

FINISH:

drive line

AQUIFERS:

Gravel

WATER LEVEL:

12 feet below surface

PUMPING EQUIPMENT: Type Fairbank, Morse Centrifugal H.P. 5

Capacity 100 G.P.M.

WELL TESTS:

Drawdown 10 ft. after hours 135 G.P.M.
Drawdown ft. after hours G.P.M.

USE OF WATER Irrigation Temp. °F., 19

SOURCE OF INFORMATION Well Registration Statement

DRILLER or DIGGER

ADDITIONAL DATA:

Log X Water Level Measurements Chemical Analysis Aquifer Test

REMARKS:

Log:	Thickness	Depth to Bottom
Top soil	20	22
Gravel	2	20