


11951

OWNER: Page Walton
MAILING ADDRESS: 1225 Beacon Drive
CITY AND STATE: Eugene, Oregon

LOCATION OF WELL: Owner's No. N. E.
NW 1/4 NE 1/4 Sec. 12 T. 17 S. R. 4 W., W.M.

Bearing and distance from section or subdivision
corner 1460' N. 40° W. to NW cor. of NW 1/4 NE 1/4 of Sec. 12

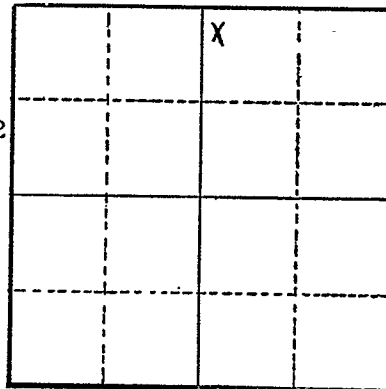

Section 12

Altitude at well

TYPE OF WELL: Drilled Date Constructed 1940

Depth drilled 22 feet Depth cased 22 feet

CASING RECORD:

5 inch casing set to 22 feet

FINISH:

AQUIFERS:

WATER LEVEL:

9 feet below surface

PUMPING EQUIPMENT: Type Fairbanks Morse H.P. 10
Capacity 200 G.P.M.

WELL TESTS:

Drawdown ft. after hours 200 G.P.M.
Drawdown ft. after hours G.P.M.

USE OF WATER Irrigation Temp. °F. 19

SOURCE OF INFORMATION Well Registration Statement

DRILLER or DIGGER

ADDITIONAL DATA:

Log Water Level Measurements Chemical Analysis Aquifer Test

REMARKS: