

STATE ENGINEER
Salem, Oregon

Well Record **LANE** STATE WELL NO. 17/4W-12B
11952 COUNTY Lane
GR- 1314 APPLICATION NO. GR- 1359

OWNER: Orlando A. or Alice A. Cummins


MAILING ADDRESS: 1090 River Loop #1

LOCATION OF WELL: Owner's No. #1

CITY AND STATE: Eugene, Oregon

NW 1/4 NE 1/4 Sec. 12 T. 17 N. S., R. 4 W., W.M.

Bearing and distance from section or subdivision corner 2300' W. & 350' S. from NE cor. Sec. 12.

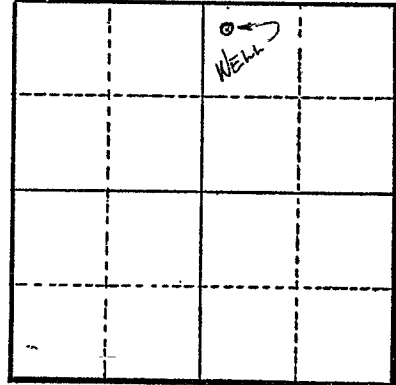

Section 12

Altitude at well 325 ft.

TYPE OF WELL: Drilled Date Constructed 1940

Depth drilled 20 ft. Depth cased 20 ft.

CASING RECORD:

4 inch

FINISH:

AQUIFERS:

WATER LEVEL:

12 ft.

PUMPING EQUIPMENT: Type F. M. 1 1/2 in. H.P. 7 1/2
Capacity 180 G.P.M.

WELL TESTS:

Drawdown ft. after hours G.P.M.
Drawdown ft. after hours G.P.M.

USE OF WATER Irrigation Temp. °F. 19

SOURCE OF INFORMATION G. R. Record

DRILLER or DIGGER Joe Richards

ADDITIONAL DATA:

Log N.A. Water Level Measurements Chemical Analysis Aquifer Test

REMARKS:

Irrigation of 17.5 acres.