

STATE ENGINEER  
Salem, Oregon

# Well Record

STATE WELL NO. 17/LW-12C  
COUNTY Lane  
APPLICATION NO. GR-1723

GR 1672

OWNER: Jack C. Cannon

MAILING ADDRESS:

LANE 11954

LOCATION OF WELL: Owner's No.


CITY AND STATE:

Eugene, Oregon

NE 1/4 NW 1/4 Sec. 12 T. 17 S. R. 4 W., W.M.

Bearing and distance from section or subdivision

corner 1460' E. & 640' S. from NW cor. Sec. 12

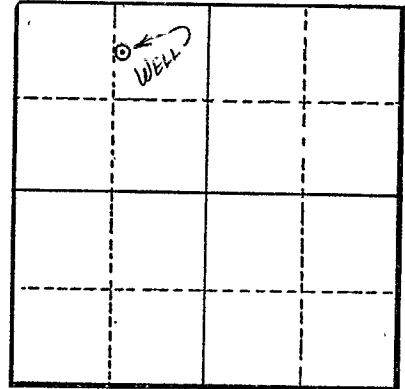

Section 12

Altitude at well 370'

TYPE OF WELL: Driven Date Constructed 1938

Depth drilled 20' Depth cased 20'

### CASING RECORD:

4"

### FINISH:

Perforated from 17 to 20 ft.

### AQUIFERS:

### WATER LEVEL:

?

PUMPING EQUIPMENT: Type F. M. Cent.  
Capacity 82 G.P.M.

H.P. 5

### WELL TESTS:

Drawdown ft. after hours G.P.M.

Drawdown ft. after hours G.P.M.

USE OF WATER Irrigation Temp. °F. 19

SOURCE OF INFORMATION GR Record

DRILLER or DIGGER

### ADDITIONAL DATA:

Log N.A. Water Level Measurements Chemical Analysis Aquifer Test

### REMARKS:

Irrigation of 5 acres.