

STATE ENGINEER  
Salem, Oregon

Well Record **LANE** STATE WELL NO. 17/4W-12C  
11955 COUNTY Lane APPLICATION NO. GR-1360

GR- 1315

OWNER: Orlando A. or Alice A. Cummins


MAILING ADDRESS: 1090 River Loop #1

LOCATION OF WELL: Owner's No. #2

CITY AND STATE: Eugene, Oregon

NE 1/4 NW 1/4 Sec. 12 T. 17 S., R. 4 W., W.M.

Bearing and distance from section or subdivision  
corner 220' S. & 2755' W. from NE cor. Sec. 12.

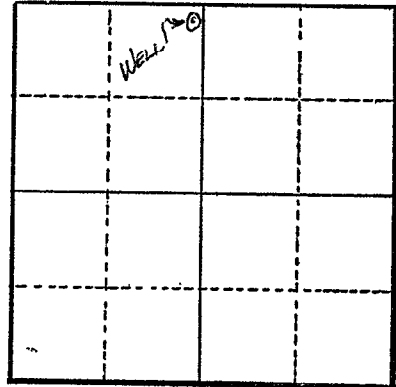

Section 12

Altitude at well 325 ft.

TYPE OF WELL: Dug Date Constructed 1942

Depth drilled 17 ft. Depth cased 17 ft.

CASING RECORD:

4 inch

FINISH:

AQUIFERS:

WATER LEVEL:

12 ft.

PUMPING EQUIPMENT: Type F. M. 1 1/2 in.

Capacity 180 G.P.M.

H.P. 7 1/2

WELL TESTS:

Drawdown ft. after hours G.P.M.

Drawdown ft. after hours G.P.M.

USE OF WATER Irrigation Temp. °F. 19

SOURCE OF INFORMATION G. R. Record

DRILLER or DIGGER Owner

ADDITIONAL DATA:

Log N.A. Water Level Measurements Chemical Analysis Aquifer Test

REMARKS:

Irrigation of 10 acres.