

STATE ENGINEER  
Salem, Oregon

# Well Record

STATE WELL NO. 17/4W-12D  
COUNTY Lane  
APPLICATION NO. GR-4245

11956

OWNER: James M. Blackford

MAILING ADDRESS: Eugene

LOCATION OF WELL: Owner's No.

CITY AND STATE: Oregon

NW 1/4 NW 1/4 Sec. 12 T. 17 N. S. R. 4 W., W.M.

Bearing and distance from section or subdivision

corner South 0° 11' West 977 feet and South 89°

34' 48" East 1949 feet from the NW Corner of


L. Poindexter DLC 52; being within the NW 1/4 NW 1/4

Section 12

Altitude at well 410 feet

TYPE OF WELL: Drilled Date Constructed 1952

Depth drilled 23 feet Depth cased 23 feet

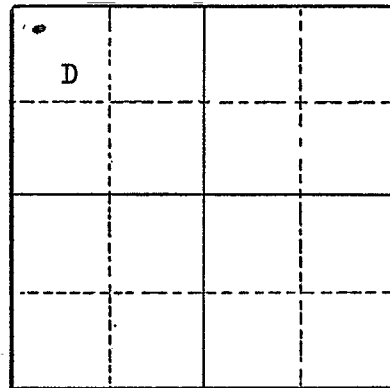

Section 12

### CASING RECORD:

4-inch casing from surface to 23 feet

### FINISH:

1/4 in. perforations

### AQUIFERS:

### WATER LEVEL:

PUMPING EQUIPMENT: Type Pacific 1 1/2" Centrifugal H.P.  
Capacity 60 G.P.M.

### WELL TESTS: never tested, never

Drawdown pumped dry ft. after hours 600 G.P.M.

Drawdown ft. after hours G.P.M.

USE OF WATER Irrigation Temp. °F. 19

SOURCE OF INFORMATION GR-4048

DRILLER or DIGGER D. A. Dickinson, 1850 River Road, Eugene, Oregon

### ADDITIONAL DATA:

Log (NA) Water Level Measurements Chemical Analysis Aquifer Test

### REMARKS: