

STATE ENGINEER
Salem, Oregon

Well Record **LANE** STATE WELL NO. 17/~~4W~~-12D.
COUNTY **LANE**
APPLICATION NO. GR-2922

OWNER: Claude D. Bedell


MAILING ADDRESS: 650 River Loop No. 1

LOCATION OF WELL: Owner's No. _____

CITY AND STATE: Eugene, Oregon

~~NW~~ ^N ~~NW~~ ^E ~~Sec. 12~~ T. 17 S., R. 4 W., W.M.

Bearing and distance from section or subdivision
corner Beginning at N.E. corner of L. Poindexter
DLC #52.

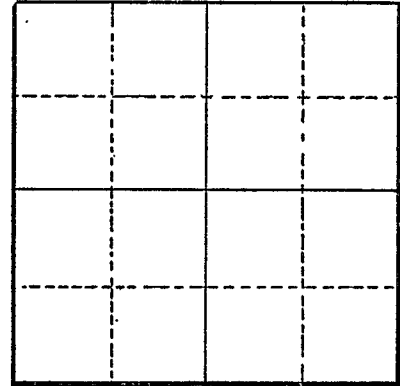

Section _____

Altitude at well _____

TYPE OF WELL: Driven Date Constructed 1954

Depth drilled 20 Depth cased _____

CASING RECORD:

FINISH:

AQUIFERS:

Soil

WATER LEVEL:

12-feet

PUMPING EQUIPMENT: Type _____ H.P. 1
Capacity 15 G.P.M.

WELL TESTS:

Drawdown _____ ft. after _____ hours _____ G.P.M.

Drawdown _____ ft. after _____ hours _____ G.P.M.

USE OF WATER Irrigation Temp. _____ °F., 19

SOURCE OF INFORMATION GR-2752

DRILLER or DIGGER _____

ADDITIONAL DATA:

Log ^X Water Level Measurements _____ Chemical Analysis _____ Aquifer Test _____

REMARKS:

Soil 5