

STATE ENGINEER
Salem, Oregon

Well Record

STATE WELL NO. 17/1W-12E
COUNTY Lane
APPLICATION NO. CR-3545

1962

OWNER: Edward J. Thene11


MAILING ADDRESS: Chapman Drive

LOCATION OF WELL: Owner's No. _____

CITY AND STATE: Eugene, Oregon

SW 1/4 NW 1/4 Sec. 12 T. 17 S., R. 4 W., W.M.

Bearing and distance from section or subdivision corner 1225 ft. N. and 1000 Ft. W. of SE corner
D.L.C. #52

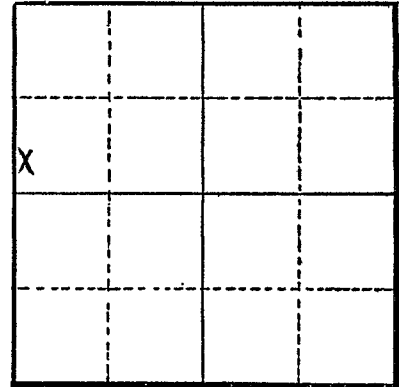

Section 12

Altitude at well _____

TYPE OF WELL: Driven Date Constructed 1954

Depth drilled 20 ft. Depth cased 20 ft.

CASING RECORD:

4 inch casing set up to 20 ft.

FINISH:

Slotted

AQUIFERS:

WATER LEVEL:

12 feet below surface

PUMPING EQUIPMENT: Type Bineham Centrifugal H.P. _____

Capacity _____ G.P.M. John Deere Tractor Model D

WELL TESTS:

Drawdown _____ ft. after _____ hours _____ G.P.M.

Drawdown _____ ft. after _____ hours _____ G.P.M.

USE OF WATER Irrigation Temp. _____ °F., 19 _____

SOURCE OF INFORMATION Well Registration Statement

DRILLER or DIGGER _____

ADDITIONAL DATA:

Log _____ Water Level Measurements _____ Chemical Analysis _____ Aquifer Test _____

REMARKS: