

STATE ENGINEER  
Salem, Oregon

# Well Record

STATE WELL NO. 17/LW-12-G  
COUNTY Lane  
APPLICATION NO. GR-3346

OWNER: Karl W. Eisenhardt


MAILING ADDRESS: 3235 James Lane LANE 11965

LOCATION OF WELL: Owner's No. \_\_\_\_\_

CITY AND STATE: Eugene, Oregon

SW 1/4 NE 1/4 Sec. 12 T. 17 N S., R. 4 E W., W.M.

Bearing and distance from section or subdivision corner 1610' W and 1321' S

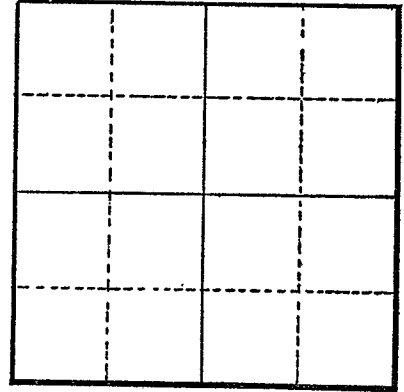

Section \_\_\_\_\_

Altitude at well \_\_\_\_\_

TYPE OF WELL: driven Date Constructed 1946

Depth drilled 21' Depth cased 21'

CASING RECORD:

2 1/2"

FINISH:

5' perforations

AQUIFERS:

Loam and gravel

WATER LEVEL:

8'

PUMPING EQUIPMENT: Type Fairbanks Morse H.P. 20  
Capacity 200 G.P.M.

WELL TESTS:

Static  
Drawdown \_\_\_\_\_ ft. after \_\_\_\_\_ hours pumping 200 G.P.M.

Drawdown \_\_\_\_\_ ft. after \_\_\_\_\_ hours \_\_\_\_\_ G.P.M.

USE OF WATER Irrigation Temp. \_\_\_\_\_ °F., 19 \_\_\_\_\_

SOURCE OF INFORMATION GR-3098

DRILLER or DIGGER \_\_\_\_\_

ADDITIONAL DATA:

Log  Water Level Measurements \_\_\_\_\_ Chemical Analysis \_\_\_\_\_ Aquifer Test \_\_\_\_\_

REMARKS:

Loam 4  
Gravel 18 21