

# Well Record

OWNER: Sam Watson

MAILING ADDRESS: 430 Hunsaker LANE 11970


LOCATION OF WELL: Owner's No. 2

CITY AND STATE: Eugene, Oregon

NW  $\frac{1}{4}$  SW  $\frac{1}{4}$  Sec. 12 T. 17 N. S., R. 4 E. W., W.M.

Bearing and distance from section or subdivision

corner S. 67° 0' E. 1350 ft.

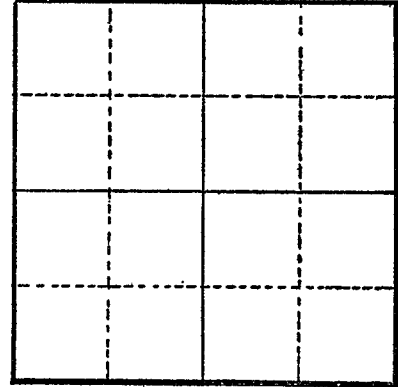

Section .....

Altitude at well .....

TYPE OF WELL: driven Date Constructed 1946

Depth drilled 21 ft. Depth cased 21 ft.

CASING RECORD: 4 inch

FINISH: Perforations from 18 to 21 ft.

AQUIFERS:

WATER LEVEL: 16 ft.

PUMPING EQUIPMENT: Type A. C. centrifugal H.P. 5  
Capacity 100 G.P.M.

WELL TESTS:

Drawdown ..... ft. after ..... hours ..... G.P.M.

Drawdown ..... ft. after ..... hours ..... G.P.M.

USE OF WATER irrigation Temp. ..... °F. ...., 19.....

SOURCE OF INFORMATION GR-2011

DRILLER or DIGGER .....

ADDITIONAL DATA:

Log ..... Water Level Measurements ..... Chemical Analysis ..... Aquifer Test .....

REMARKS: