

OWNER: Sam Watson

MAILING ADDRESS: 430 Hunsaker **LANE 11972**


LOCATION OF WELL: Owner's No. 1

CITY AND STATE: Eugene, Oregon

SW 1/4 SW 1/4 Sec. 12 T. 17 S., R. 4 W., W.M.

Bearing and distance from section or subdivision

corner S. 40° 0' E. 1780 ft.

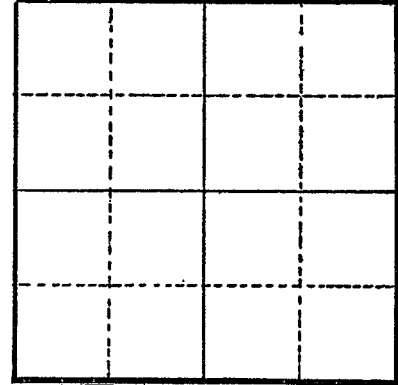

Section

Altitude at well

TYPE OF WELL: driven Date Constructed 1946

Depth drilled 21 Depth cased 21

CASING RECORD: 4 inch

FINISH: Perforations from 18 to 21 ft.

AQUIFERS:

WATER LEVEL: 16 ft.

PUMPING EQUIPMENT: Type Pacific centrifugal H.P. 3
Capacity 100 G.P.M.

WELL TESTS:

Drawdown ft. after hours G.P.M.

Drawdown ft. after hours G.P.M.

USE OF WATER irrigation Temp. °F., 19.....

SOURCE OF INFORMATION GR-2012

DRILLER or DIGGER

ADDITIONAL DATA:

Log Water Level Measurements Chemical Analysis Aquifer Test

REMARKS: