

STATE ENGINEER
Salem, Oregon

Well Record

LANE STATE WELL NO. 17/4W-13C
11992 COUNTY Lane.
APPLICATION NO. GR-4024

OWNER: Kathryn F. Wise & John C. Kilburn


MAILING ADDRESS: 311 River Ave.

LOCATION OF WELL: Owner's No.

CITY AND STATE: Eugene, Oregon

NE 1/4 NW 1/4 Sec. 13 T. 17 N. S., R. 4 E. W., W.M.

Bearing and distance from section or subdivision corner 950' W. & 640' S. from N 1/4 Cor. Sec. 13

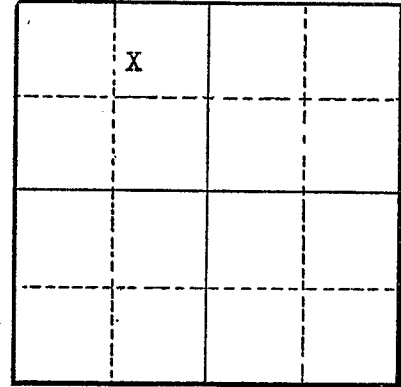

Section 13

Altitude at well

TYPE OF WELL: Driven Date Constructed May, 1943

Depth drilled 24 ft. Depth cased 24 ft.

CASING RECORD:

2 - 2 1/2 inch casing set to 24 feet

FINISH:

2 - 2 1/2 inch manifold, slotted from 20 to 24 feet

AQUIFERS:

WATER LEVEL:

12 feet below surface

PUMPING EQUIPMENT: Type 2" x 1 1/2" close coupled
Capacity 120 G.P.M.

H.P. 5

WELL TESTS:

Drawdown ft. after hours G.P.M.

Drawdown ft. after hours G.P.M.

USE OF WATER Irrigation Temp. °F., 19

SOURCE OF INFORMATION Well Registration Statement Cert. # GR-3624

DRILLER or DIGGER

ADDITIONAL DATA:

Log Water Level Measurements Chemical Analysis Aquifer Test

REMARKS: