

STATE ENGINEER  
Salem, Oregon

Well Record **LANE** STATE WELL NO. 17/4W-13C  
COUNTY Lane  
APPLICATION NO. GR-3911


11993

OWNER: James W. Merwin  
Dorothy E. Merwin  
LOCATION OF WELL: Owner's No. \_\_\_\_\_

MAILING ADDRESS: 501 River Ave.  
CITY AND STATE: Eugene, Oregon

NE 1/4 NW 1/4 Sec. 13 T. 17 S., R. 4 W., W.M.

Bearing and distance from section or subdivision  
corner 630' S. of the NW Cor. Lot H thence E. 231'

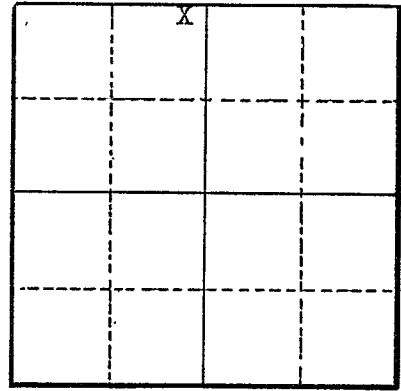

Section 13

Altitude at well \_\_\_\_\_

TYPE OF WELL: Driven Date Constructed May, 1935  
Depth drilled 21 feet Depth cased 21 feet

CASING RECORD:

4 inch casing set to 21 feet

FINISH:

slotted perforations from 17 1/2 to 21 feet

AQUIFERS:

WATER LEVEL:

12 feet below surface

PUMPING EQUIPMENT: Type Deming pump H.P. 5  
Capacity 1200 G.P.M. H.

WELL TESTS:

Drawdown \_\_\_\_\_ ft. after \_\_\_\_\_ hours \_\_\_\_\_ G.P.M.  
Drawdown \_\_\_\_\_ ft. after \_\_\_\_\_ hours \_\_\_\_\_ G.P.M.

USE OF WATER Irrigation Temp. \_\_\_\_\_ °F., 19

SOURCE OF INFORMATION Well Registration Statement Cert. # GR-3550

DRILLER or DIGGER \_\_\_\_\_

ADDITIONAL DATA:

Log \_\_\_\_\_ Water Level Measurements \_\_\_\_\_ Chemical Analysis \_\_\_\_\_ Aquifer Test \_\_\_\_\_

REMARKS: