

STATE ENGINEER
Salem, Oregon

Well Record

STATE WELL NO. 17/4W-13D
COUNTY LANE
APPLICATION NO. GR-2979

LANE
12000

OWNER: Marvin M. Cornutt


MAILING ADDRESS: 121 River Ave

LOCATION OF WELL: Owner's No.

CITY AND STATE: Eugene, Oregon

NW 1/4 NW 1/4 Sec. 13 T. 17 S., R. 4 W., W.M.

Bearing and distance from section or subdivision corner 700' S & 300' E from NW cor Sec 13

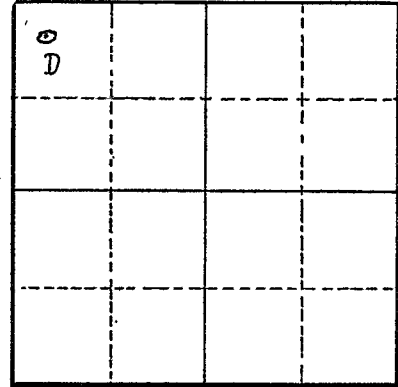

Section 13

Altitude at well

TYPE OF WELL: Driven Date Constructed 1938

Depth drilled 21' Depth cased 21'

CASING RECORD:

2-inch

FINISH:

slotted

AQUIFERS:

WATER LEVEL:

12'

PUMPING EQUIPMENT: Type Pacific Centrifugal Capacity G.P.M.

H.P. 1

WELL TESTS:

Drawdown ft. after hours 40 G.P.M.

Drawdown ft. after hours G.P.M.

USE OF WATER Irrigation Temp. °F., 19

SOURCE OF INFORMATION GR-3908

DRILLER or DIGGER

ADDITIONAL DATA:

Log NA Water Level Measurements Chemical Analysis Aquifer Test

REMARKS: