

STATE ENGINEER
Salem, Oregon

Well Record

STATE WELL NO. 17/4W-13D
COUNTY Lane
APPLICATION NO. GR-3245

OWNER: A. R. & D. W. Shaffner aka
Shaffner Brothers


MAILING ADDRESS: 211 River Avenue

LOCATION OF WELL: Owner's No. #2

CITY AND STATE: Eugene, Oregon

NW 1/4 NW 1/4 Sec. 13 T. 17 N. S., R. 4 E. W., W.M.

Bearing and distance from section or subdivision
corner S. 61° 45' E. 1240' from the N.W.
corner of Section 13

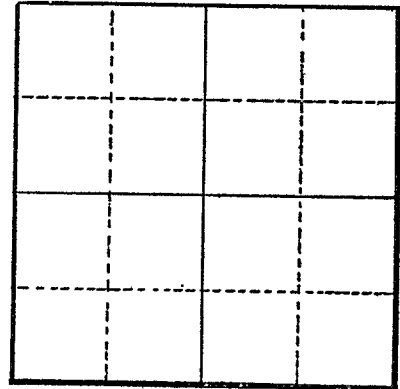

Section

Altitude at well

TYPE OF WELL: driven Date Constructed 1936

Depth drilled 24 Depth cased 24

CASING RECORD:

4 inch

FINISH:

1/2" perforation from 21 to 24

AQUIFERS:

WATER LEVEL:

12 feet

PUMPING EQUIPMENT: Type Fairbanks Morse electric H.P. 10
Capacity 300 G.P.M.

WELL TESTS:

Drawdown ft. after hours Pumping 300 G.P.M.
Drawdown ft. after hours G.P.M.

USE OF WATER Irrigation Temp. °F. 19

SOURCE OF INFORMATION GR-3020

DRILLER or DIGGER Shaffner Brothers

ADDITIONAL DATA:

Log Water Level Measurements Chemical Analysis Aquifer Test

REMARKS: