

STATE ENGINEER  
Salem, Oregon

Well Record **LANE** ESTATE WELL NO. **17/LW - 13D**  
1200<sup>3</sup> COUNTY **LANE**  
APPLICATION NO. **GR-2136**

OWNER: **Anton Reinholtz**


MAILING ADDRESS: **55 River Avenue**

LOCATION OF WELL: Owner's No. \_\_\_\_\_

CITY AND STATE: **Eugene, Oregon**

NW  $\frac{1}{4}$  NW  $\frac{1}{4}$  Sec. **13** T. **17** N. S., R. **4** W., W.M.

Bearing and distance from section or subdivision corner **699.44' S. 17 $\frac{1}{4}$ ° E.**

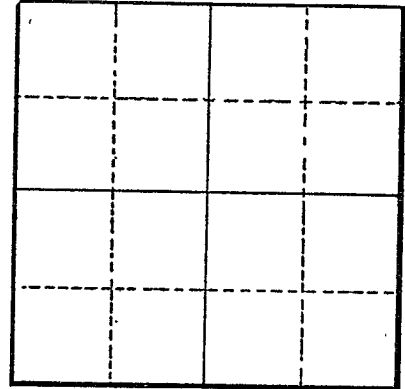

Section \_\_\_\_\_

Altitude at well \_\_\_\_\_

TYPE OF WELL: **Driven** Date Constructed **1949**

Depth drilled **24** Depth cased **24**

CASING RECORD:

**2 -2 $\frac{1}{2}$  inch**

FINISH:

**Perforations from 20 $\frac{1}{2}$  to 24**

AQUIFERS:

WATER LEVEL:

**12-feet**

PUMPING EQUIPMENT: Type **2 X 1 $\frac{1}{2}$  Inch** H.P. **5**  
Capacity **120.0** G.P.M.

WELL TESTS:

Drawdown **5** ft. after \_\_\_\_\_ hours **Pumping 1200** G.P.M.  
Drawdown \_\_\_\_\_ ft. after \_\_\_\_\_ hours \_\_\_\_\_ G.P.M.

USE OF WATER **Irrigation** Temp. \_\_\_\_\_ °F. \_\_\_\_\_, 19\_\_\_\_

SOURCE OF INFORMATION **GR-2049**

DRILLER or DIGGER \_\_\_\_\_

ADDITIONAL DATA:

Log \_\_\_\_\_ Water Level Measurements \_\_\_\_\_ Chemical Analysis \_\_\_\_\_ Aquifer Test \_\_\_\_\_

REMARKS: