

STATE ENGINEER  
Salem, Oregon

Well Record LANE STATE WELL NO. 17/4W-13E(1)  
COUNTY Lane  
12004 APPLICATION NO. GR-377

OWNER: James D. Brown


MAILING ADDRESS: 120 Owasso Drive

LOCATION OF WELL: Owner's No. 2

CITY AND STATE: Eugene, Oregon

SW 1/4 NW 1/4 Sec. 13 T. 17 N. S., R. 4 E. W., W.M.

Bearing and distance from section or subdivision  
corner 3943.1 ft. N. 87° 28' E. from SW cor.  
Joseph Davis DLC 48

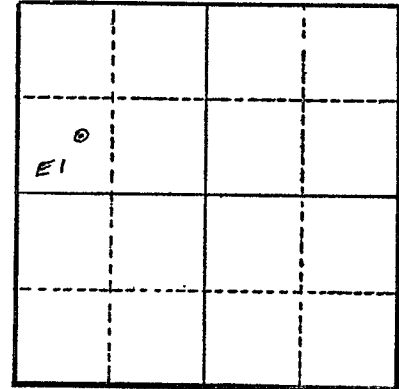

Section 13

Altitude at well 395

TYPE OF WELL: driven Date Constructed June 1944

Depth drilled 20 Depth cased none

CASING RECORD: 2 inch

FINISH:

AQUIFERS:

WATER LEVEL: 11 - 15 ft.

PUMPING EQUIPMENT: Type centrifugal H.P. 1 1/2  
Capacity 60 G.P.M.

WELL TESTS:

Drawdown \_\_\_\_\_ ft. after \_\_\_\_\_ hours \_\_\_\_\_ G.P.M.

Drawdown \_\_\_\_\_ ft. after \_\_\_\_\_ hours \_\_\_\_\_ G.P.M.

USE OF WATER irrigation 31 acres Temp. \_\_\_\_\_ °F., 19

SOURCE OF INFORMATION GR-377

DRILLER or DIGGER \_\_\_\_\_

ADDITIONAL DATA:

Log \_\_\_\_\_ Water Level Measurements \_\_\_\_\_ Chemical Analysis \_\_\_\_\_ Aquifer Test \_\_\_\_\_

REMARKS: